
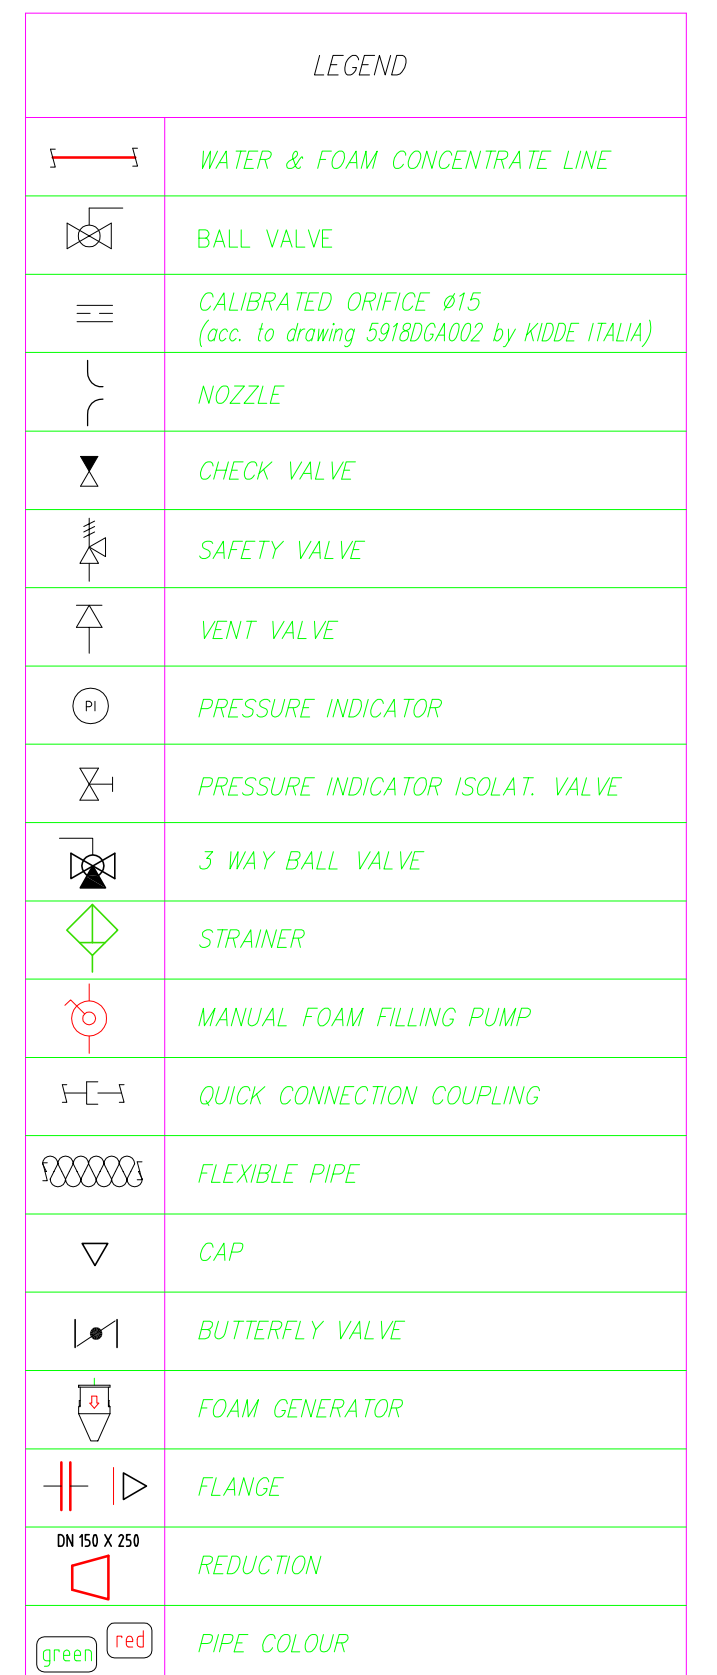
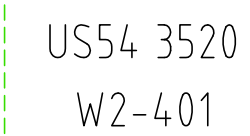


If not indicated in the drawing
the pipe material is ST35-8

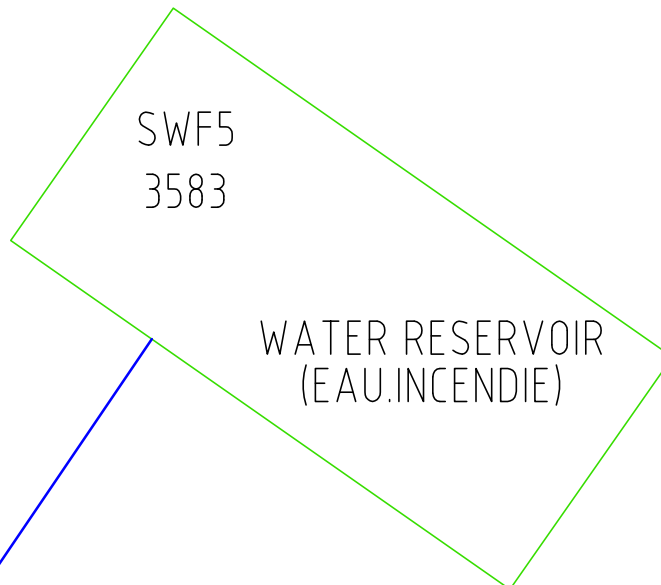

ENSEMBLE ELEMENT		FIRE FIGHTING FOAM SYSTEM PIPING & INSTRUMENT DIAGRAM - AS BUILT				v.00
DESIGNED	NAME	DATE	ECHELLE SCALE —	DES/DRA. CONTROLLED	DES/DRA.	DES/DRA.
RELEASED	M.Sc. Wojciech Szczepny	28.11.2013		RELEASED		
CONTROLLED				APPROVED		
APPROVED				FILE NAME		
3D maker				QAC	REPLACE /REPLACES	
					SIZE 2	IND. IN