


If not indicated in the drawing
the pipe material is ST35-8




WATER RESERVOIR
(EAU INCENDIE)

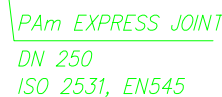

TEMPERATURE PROBE
JUMO

WATER RESERVOIR

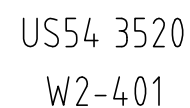

ORIGINAL DRAWINGS BY
KIDDE ITALIA
SHOW A CHECK VALVE
IN THIS POSITION.
NOT POSSIBLE TO VERIFY
WITHOUT PIPE DISMANTLING.

NO INDICATION OF EXISTENCE. PIPE
DISMANTLE NECESSARY IN ORDER TO
VERIFY IF Ø85 NOZZLE IS INSIDE DN150
PIPE (MIXER).



	WATER & FOAM CONCENTRATE LINE
	BALL VALVE
	CALIBRATED ORIFICE Ø15 (acc. to drawing 59180GA002 by KIDDE ITALIA)
	NOZZLE
	CHECK VALVE
	SAFETY VALVE
	VENT VALVE
	PRESSURE INDICATOR
	PRESSURE INDICATOR ISOLAT. VALVE
	3 WAY BALL VALVE
	STRAINER
	MANUAL FOAM FILLING PUMP
	QUICK CONNECTION COUPLING
	FLEXIBLE PIPE
	CAP
	BUTTERFLY VALVE
	FOAM GENERATOR
	FLANGE
	REDUCTION
	PIPE COLOUR

Bends $Dn40, R=0,0D : 2 \times 10^\circ$

ENSEMBLE ELEMENT		FIRE FIGHTING FOAM SYSTEM							PIPING & INSTRUMENT DIAGRAM - AS BUILT		v.01				
DESIGNED		NAME		DATE		ECHELLE SCALE		DES/DRA.		DES/DRA.		DES/DRA.			
RELEASED		M.Sc. Wojciech Szczesny		13.03.2014				CONTROLLED							
CONTROLLED								RELEASED							
APPROVED								APPROVED							
								FILE NAME							
3D maker								REPLACE/REPLACES							
						QAC						SIZE		IND.	
												2		IN	